




ILSF VOLUME CALCULATION
VOLUMES BY TRIANGULATION (PRISMS) 1/18/2016 14:35
ORIGINAL SURFACE: C:\USERS\SSAWYER.DC\DOCUMENTS\BOYD\SITE-TOPO.TIN
FINAL SURFACE: ELEVATION OF 55.60 FEET
AREA IN FILL: 222,431.0 S.F., 5.11 ACRES
AVERAGE FILL DEPTH: 1.49 FEET
TOTAL INCLUSION AREA: 492,721.6 S.F., 11.31 ACRES
FILL VOLUME: 330,488.6 C.F., 12,240.32 C.Y.

1968
revised / Lynn Marsh -
MHD bought sand
from Evergreen site
and upon return, took
back marsh soils.
120 truck dumps
(per Ted Norton
local contractor)

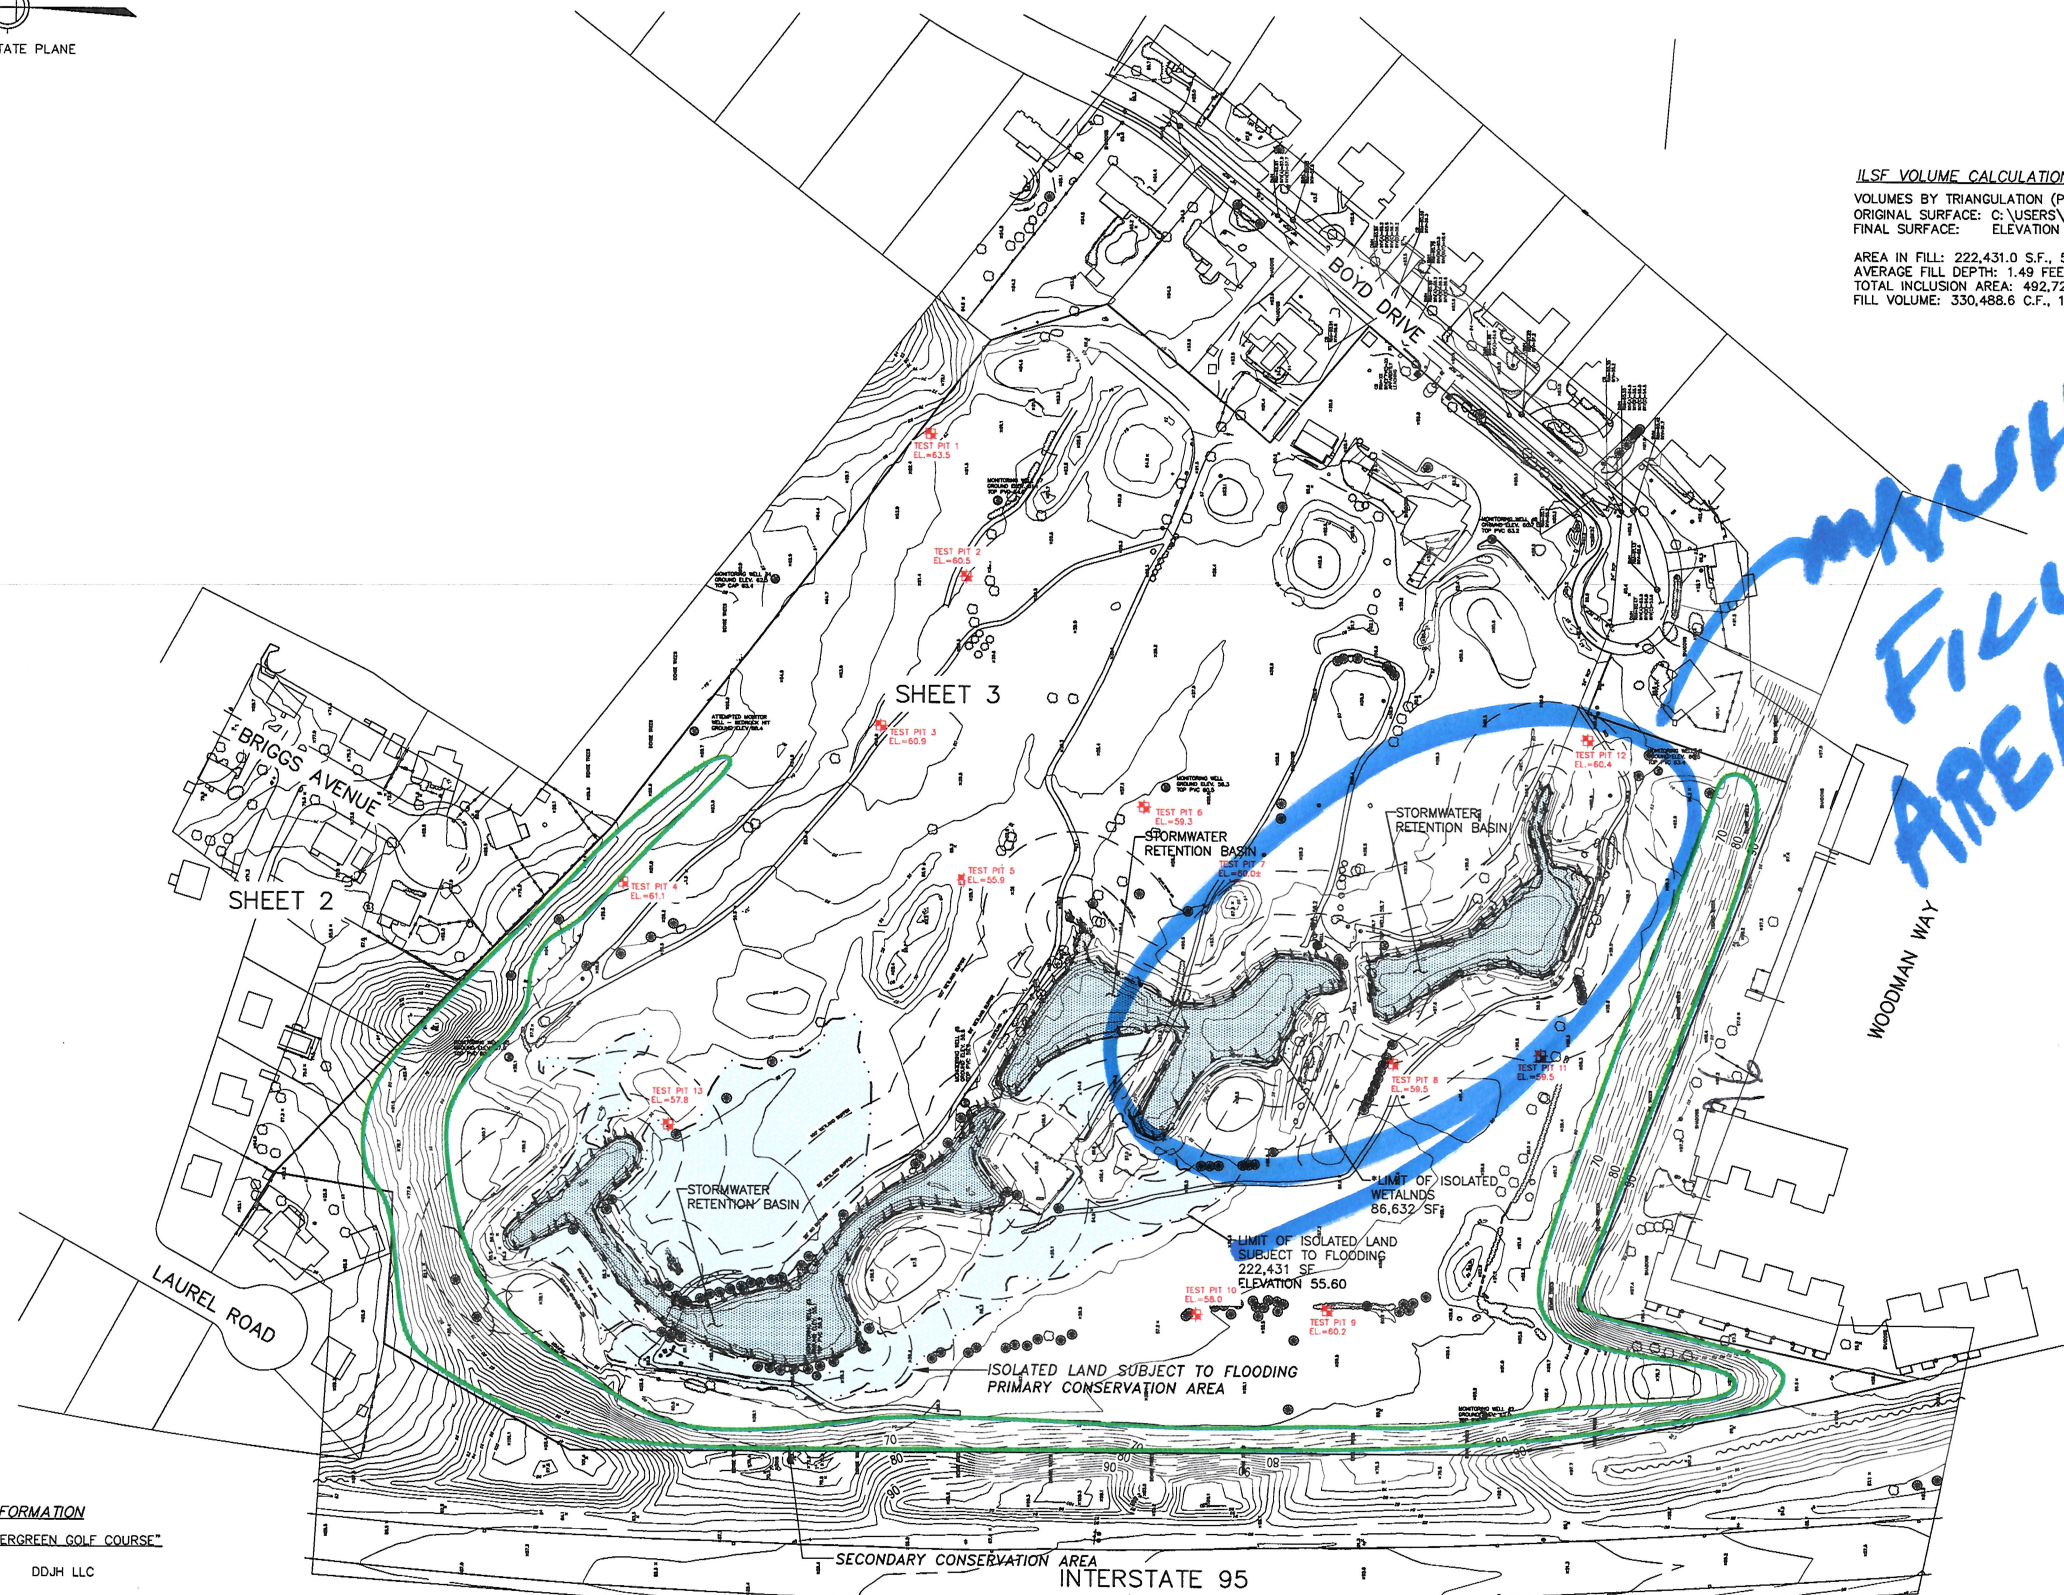

LOCUS TITLE INFORMATION

18 BOYD DRIVE "EVERGREEN GOLF COURSE"

OWNER: DDJH LLC

DEED REFERENCE: BOOK 29288 PAGE 376

ASSESSORS: MAP 110 PARCEL 20

NOTES

THE PURPOSE OF THIS PLAN IS TO SHOW THE EXISTING CONDITIONS OF THE LOCUS PROPERTY FOR DESIGN PURPOSES AND IS THE RESULT OF AERIAL MAPPING PERFORMED IN 2015 BASED ON 2010 FLIGHTS AS UPDATED BY AN ACTUAL ON THE GROUND SURVEY PERFORMED DURING NOVEMBER 2015 AND JANUARY 2016. EXISTING CONDITIONS PLAN COMPLETED BY WINTER GEC LLC.

WETLANDS WERE DELINEATED BY HUGHES ENVIRONMENTAL CONSULTANTS IN NOVEMBER 17 AND 18, 2015.


ELEVATIONS SHOWN HEREON ARE BASED ON NAVD8 DATUM AND HORIZONTAL DATUM IS MASSACHUSETTS STATE PLANE COORDINATES NAD83 ZONE MASS MAINLAND 2001.

OWNERSHIP INFORMATION USED IN THE PREPARATION OF THIS PLAN WAS OBTAINED FROM THE CLIENT AND THE CITY OF NEWBURYPORT ASSESSOR'S OFFICE IN NOVEMBER 2015.

ALL PLAN AND DEED REFERENCES REFER TO THE SOUTHERN ESSEX DISTRICT REGISTRY OF DEEDS.

UTILITIES SHOWN HEREON ARE BASED ON RECORD PLANS OBTAINED FROM THE RESPECTIVE UTILITY OWNERS. INVERTS ARE BASED ON ACTUAL FIELD MEASUREMENTS.

* ISOLATED WETLANDS SHOWN ARE NOT JURISDICTIONAL UNDER WETLANDS PROTECTION ACT OR NEWBURYPORT WETLANDS ORDINANCE

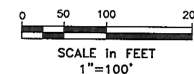

Copyright 2016 Design Consultants, Inc.

Design Consultants, Inc.
Consulting Engineers and Surveyors

120 MIDDLESEX AVENUE
SOMERVILLE, MA 02145
617-776-3350

68 PLEASANT STREET
NEWBURYPORT, MA 01950
978-358-7173

SCALE:
HORIZ: 1"= 100'
VERT: _____

NO.	DATE	BY	REVISIONS
3.	9-14-16	SBS	ADD CONSERVATION AREAS AND O.W. WELLS
2.	3-10-16	SBS	RETENTION BASINS NOTE
1.	2-10-16	SBS	ADD TEST PIT LOCATIONS

FIELD: SBS
CALCS: SW
CHECKED: SBS
APPROVED: SBS

EXISTING CONDITIONS PLAN
TO ACCOMPANY ANRAD

18 BOYD DRIVE
EVERGREEN GOLF COURSE

PLAN OF LAND IN
NEWBURYPORT, MASSACHUSETTS
SURVEYED FOR
EVERGREEN COMMONS, LLC

PROJECT NO.
18BOYD
DATE: JAN. 18, 2016
SHEET NO.
1 OF 3