
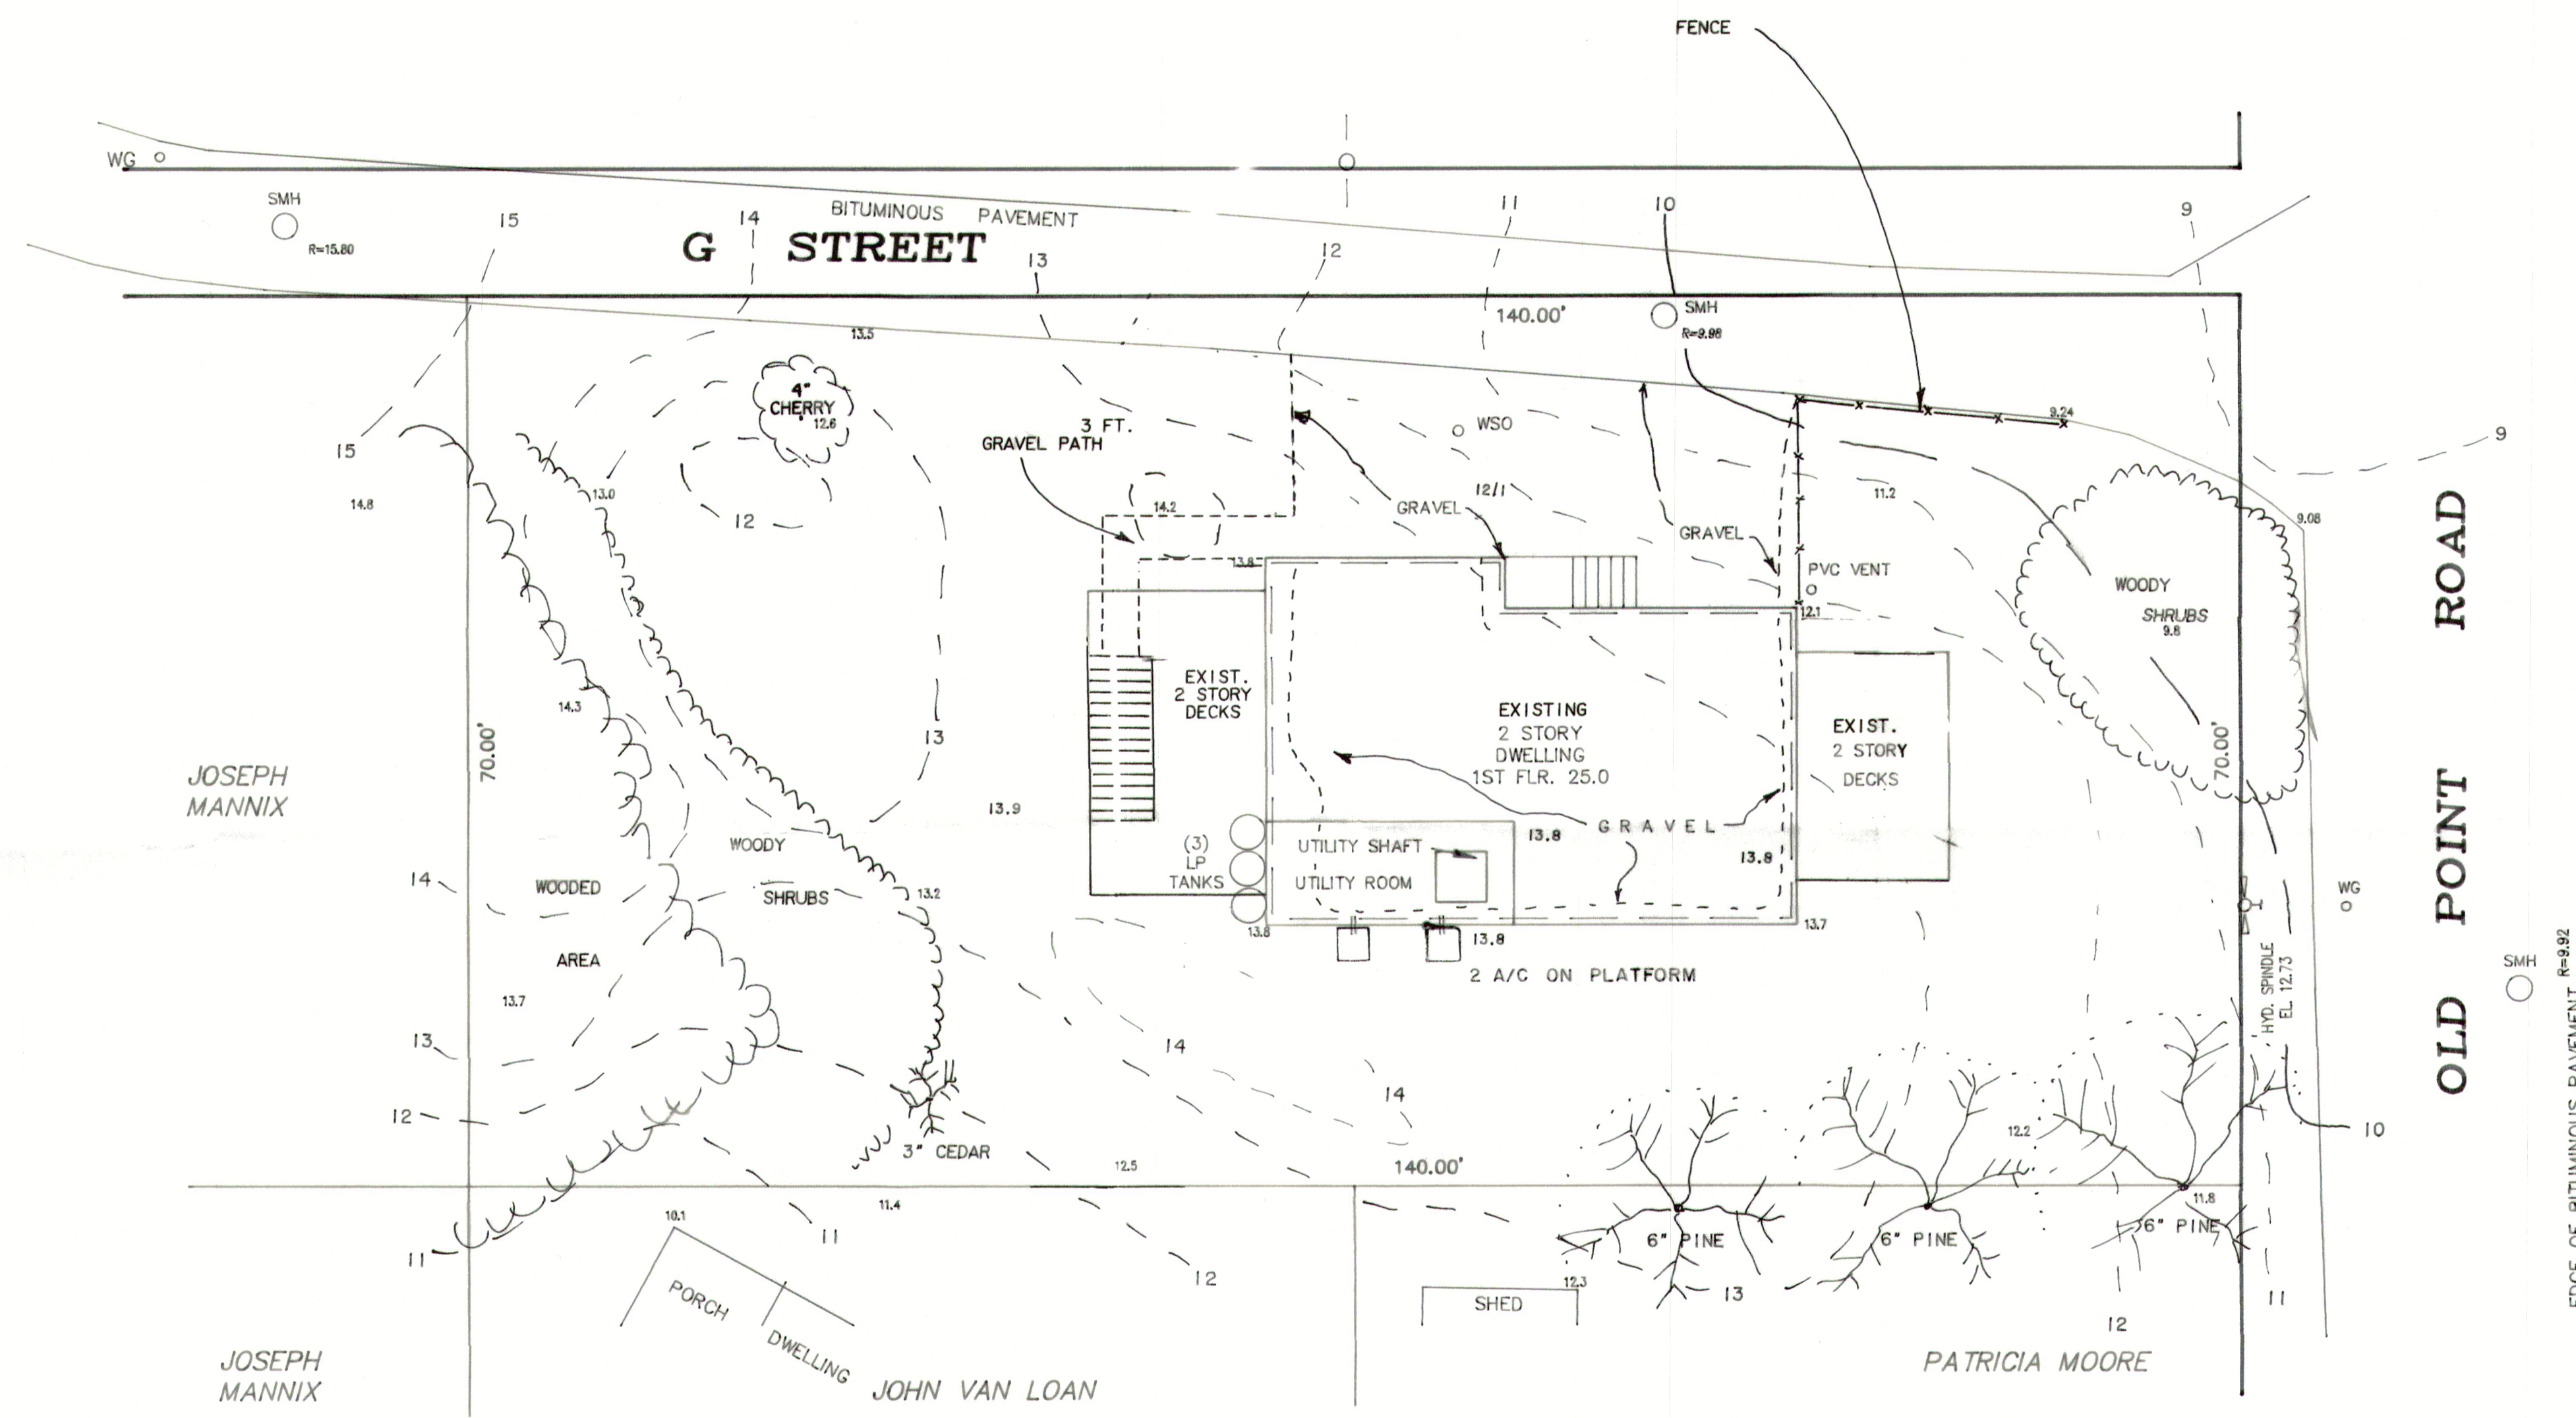


ASSESSORS MAP 75 PARCEL 13
 DEED REFERENCE: BOOK 24852 PAGE 489
 PLAN REFERENCE: PLAN 348 OF 1976

ZONING DISTRICT: R3 - P10D
 DEP FILE: 51 - 0966
 FLOOD ZONE AE ELEVATION 9: FEMA MAP 25009 C0137G
 BENCHMARK: USC&GS DISC SET IN EAST ABUTMENT
 REMAINS OF OLD HIGHWAY BRIDGE OVER PLUM IS. RIVER
 PLAN DATUM BASED ON NAVD 88

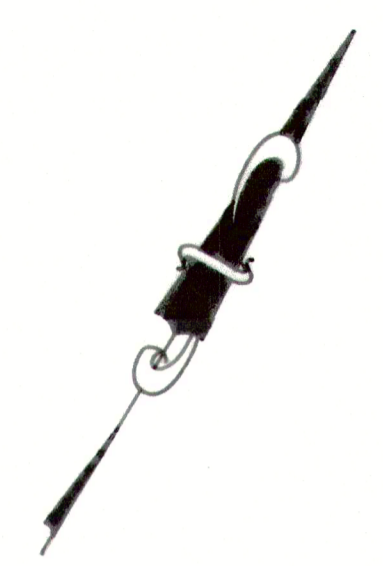

LEGEND

- SMH EXISTING SEWER MANHOLE
- DMH EXISTING DRAIN MANHOLE
- CB EXISTING CATCH BASIN
- ⊕ EXISTING HYDRANT
- ⊕ EXISTING WATER GATE
- 100 — EXISTING CONTOUR
- 100.00 — EXISTING SPOT GRADE
- ⊕ UTILITY POLE
- — — — — RETAINING WALL
- — — — — STONE WALL
- — — — — CURB
- x — x — FENCE



Christopher R. Mello

PHOTO REPRODUCTION OF THE ABOVE SEAL IS INDICATIVE OF UNAUTHORIZED REPRODUCTION OF THIS PLAN AND IS TO BE CONSIDERED A COPYRIGHT INFRINGEMENT AND/OR FRAUD. ENFORCEMENT AUTHORITY SHALL NOT ACCEPT PHOTO REPRODUCTION FOR ANY PURPOSE.


AS-BUILT / CERTIFICATE OF COMPLIANCE PLAN

LOCATED IN
NEWBURYPORT, MASS.

1 G STREET
 PREPARED BY
 EASTERN LAND SURVEY ASSOCIATES, INC.
 CHRISTOPHER R. MELLO, PLS
 104 LOWELL ST. PEABODY, MA. 01960
 (978) 531-8121

SCALE: 1" = 10' JANUARY 7, 2019
 REV. AUG. 9, 2022

RICHFIELD COMPANY, LLC

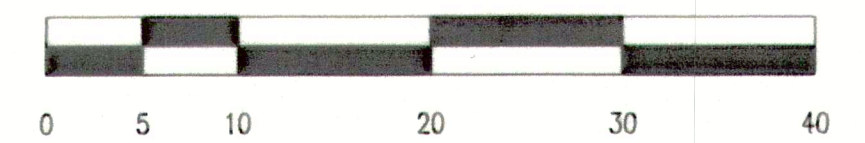

F 18327