

NEWBURYPORT
PLANNING BOARD:

DATE: _____

FOR REGISTRY USE ONLY


**SITE PLAN
OF LAND LOCATED IN
NEWBURYPORT
MASSACHUSETTS**

PREPARED FOR
OWNER & APPLICANT
SIX PERKINS WAY NOMINEE TRUST
C/O ANTHONY BARBARIS, TRUSTEE
4 PERKINS WAY
NEWBURYPORT, MA 01950


PREPARED BY
**WGH LAND SURVEY
& DESIGN**
83 WEST MAIN STREET
MERRIMAC, MA 01860
TEL: (978) 346-7873
CELL: (978) 257-4576
e-mail: billholt@aol.com

ASSESSOR'S DATA:
NEWBURYPORT: MAP No. 78
LOT No. 8-A-2, 9
NEWBURY: MAP No. R47
LOT No. 32

I HEREBY CERTIFY THAT THIS
PLAN CONFORMS TO THE RULES
AND REGULATIONS OF THE
REGISTRY OF DEEDS.

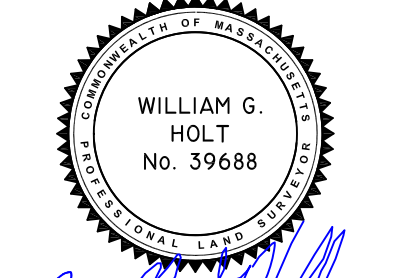

WILLIAM G. HOLT PLS, RS, SE

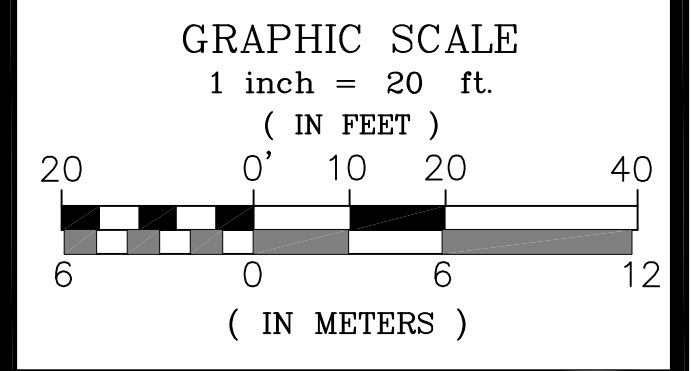

PROJECT TITLE:
**#5 & #6 PERKINS WAY
PROPOSED CONDITIONS
SITE PLAN**

DRAWN:	W.HOLT
DESIGNED:	W.HOLT, T. BERRY
CHECKED:	W.HOLT, T. BERRY
DATE:	20-MARCH-15
CAD FILE:	WGH/SITE/6PERK_SH4_(6-25)
JOB No.	014-015-03_SP

REVISION :	BY
10-28-16 REV. BUILDING & DRIVE	WH/TB
02/09/20 LOAD DOCKS	WH/TB

SHEET No. **3 OF 7**