



EXISTING SMH
RIM=84.25
8"IN=71.25(N)
8"IN=71.15(S)
8"IN=71.05(E)

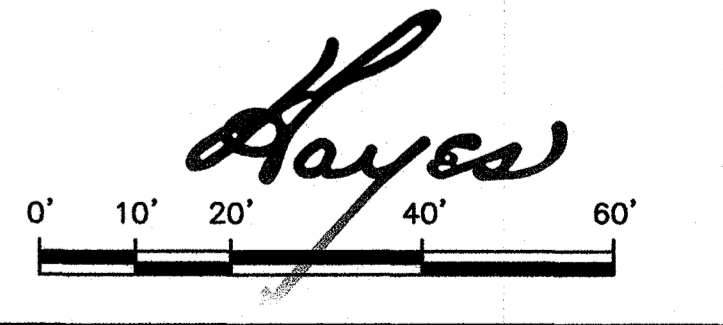

LOT LINES TAKEN FROM PLAN BY MILLENNIUM ENGINEERING, INC. DATED AUG. 28, 2015
AND FILED IN ESSEX REGISTRY OF DEEDS IN PLAN BOOK 452 PLAN 12

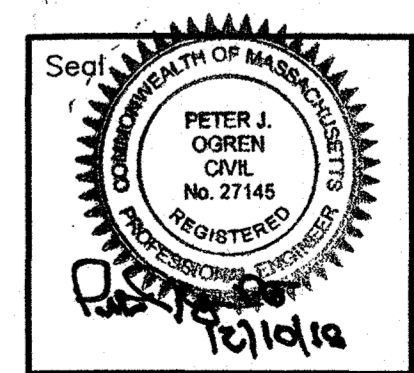

**AS BUILT PLAN
ARTICHOKE TERRACE
NEWBURYPORT, MA**

Hayes Engineering, Inc. Developer/Owner
Civil Engineers & Land Surveyors North Shore Auto Auction
603 Salem Street Frank Iovanello
Wakefield, MA 01880 23 Aaron Drive
Topsfield, Ma. 01983

Scale: 1" = 20'