



EXISTING FRONT ELEVATION

SCALE: 1/4"=1'-0"

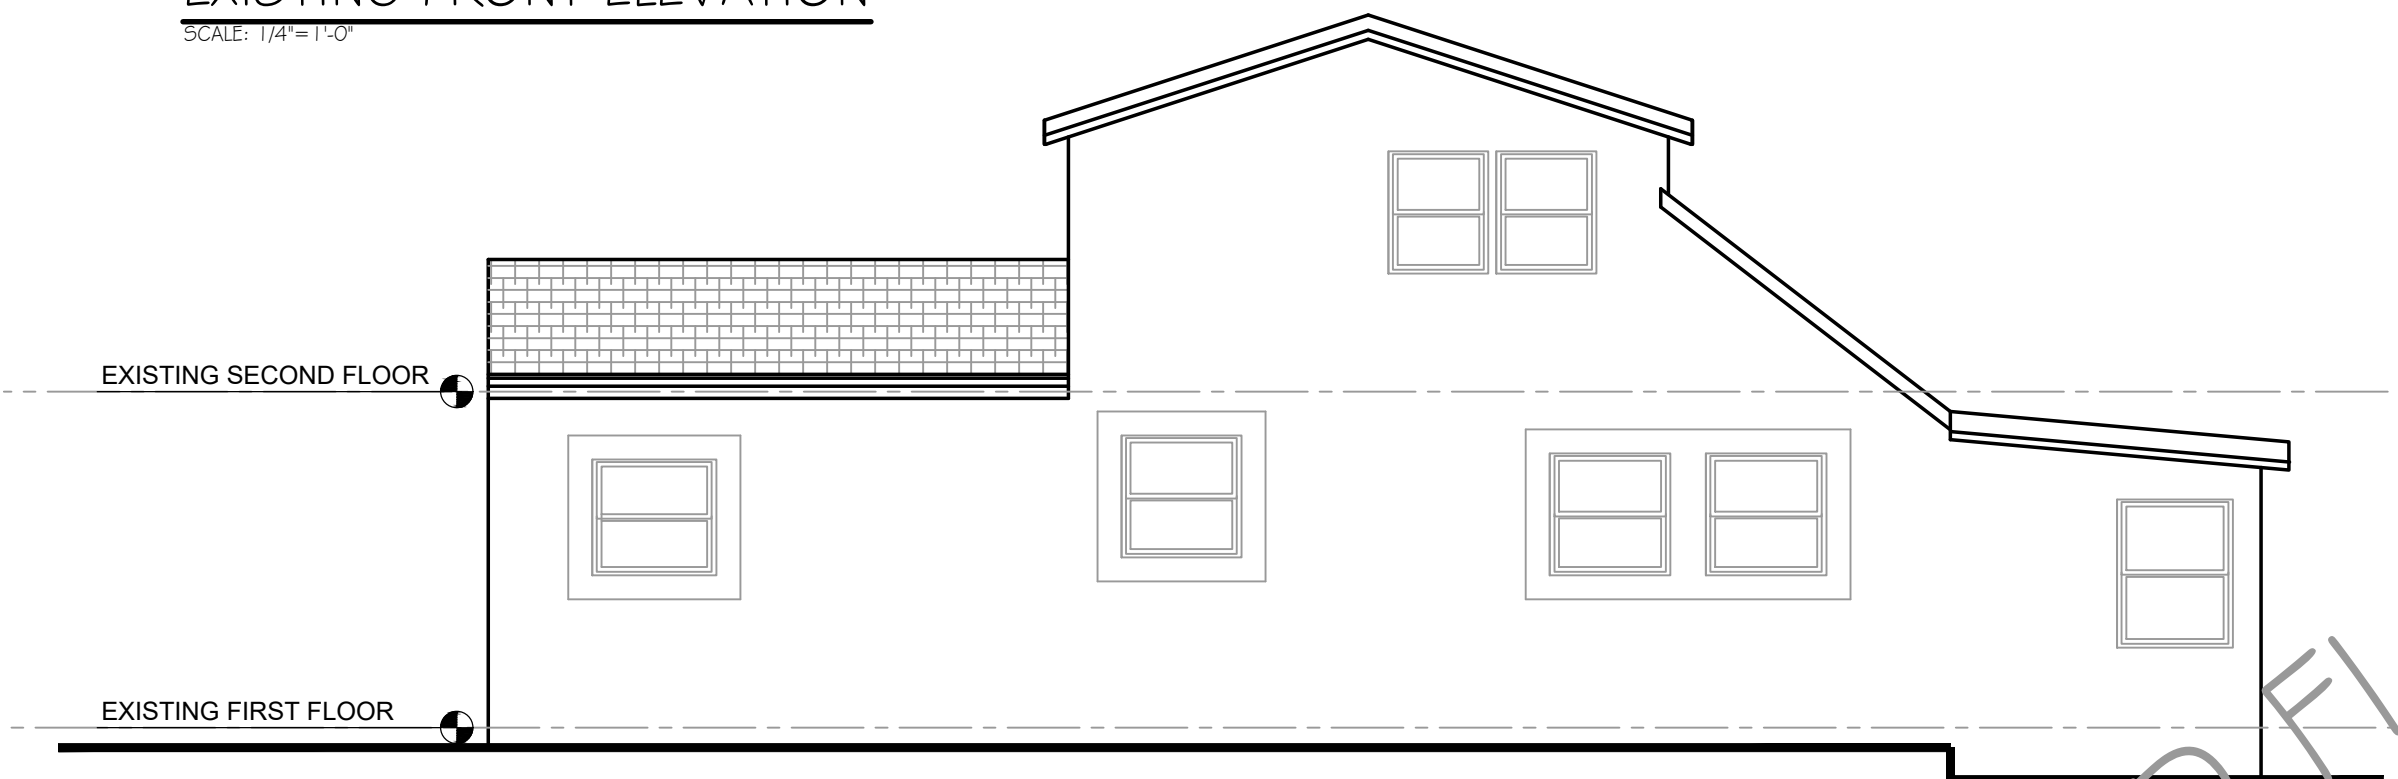

EXISTING SIDE ELEVATION

SCALE: 1/4"=1'-0"

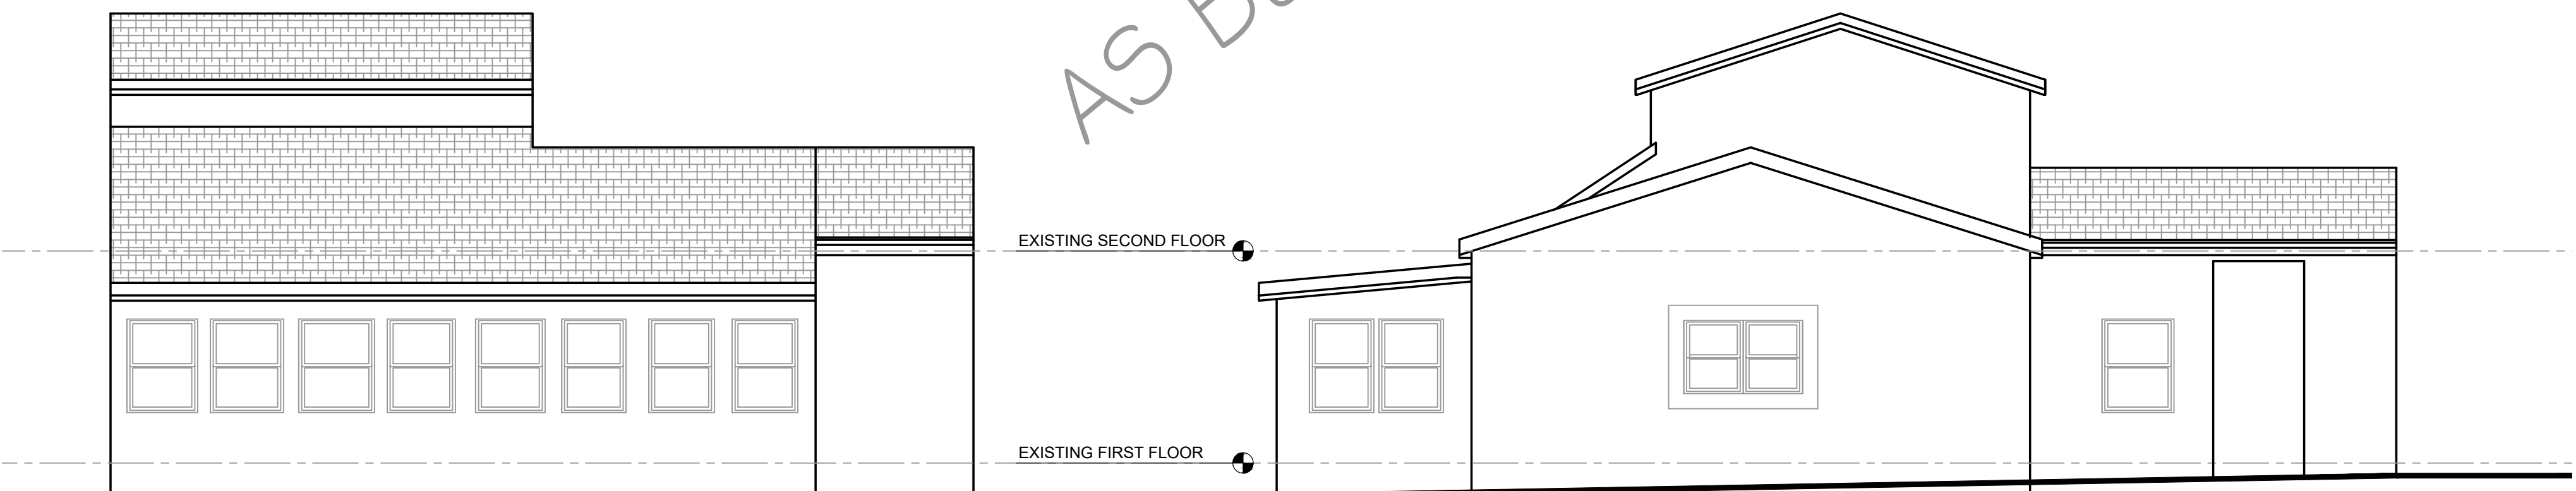

EXISTING REAR ELEVATION

SCALE: 1/4"=1'-0"

EXISTING SIDE ELEVATION

SCALE: 1/4"=1'-0"

AS BUILT FLOOR PLANS BY CHP