

INTERIM AS-BUILT PLAN SEPTEMBER 29, 2021:


TOP COURSE TO BE COMPLETED

Conceptual Cost Estimate				Boyd Drive - Remaining Work Summary	
Item Number*	Item	Unit	Unit Cost (\$)**	Quantity	Cost
450.23	Bituminous Concrete Paving	TON	150.00	246	\$36,900.00
476.	Cement Concrete Pavement (Sidewalk)**	SY	80.00	0	\$0.00
506.		FT	68.00	0	\$0.00
Total					\$36,900.00


Note: The prices shown above are for conceptual purposes only and were calculated without the use of design plans
*Taken from MassDOT's Standard Items List
**Unit cost based on MassDOT Bid Prices District 4 4/13/21



TOP COURSE TO BE COMPLETED

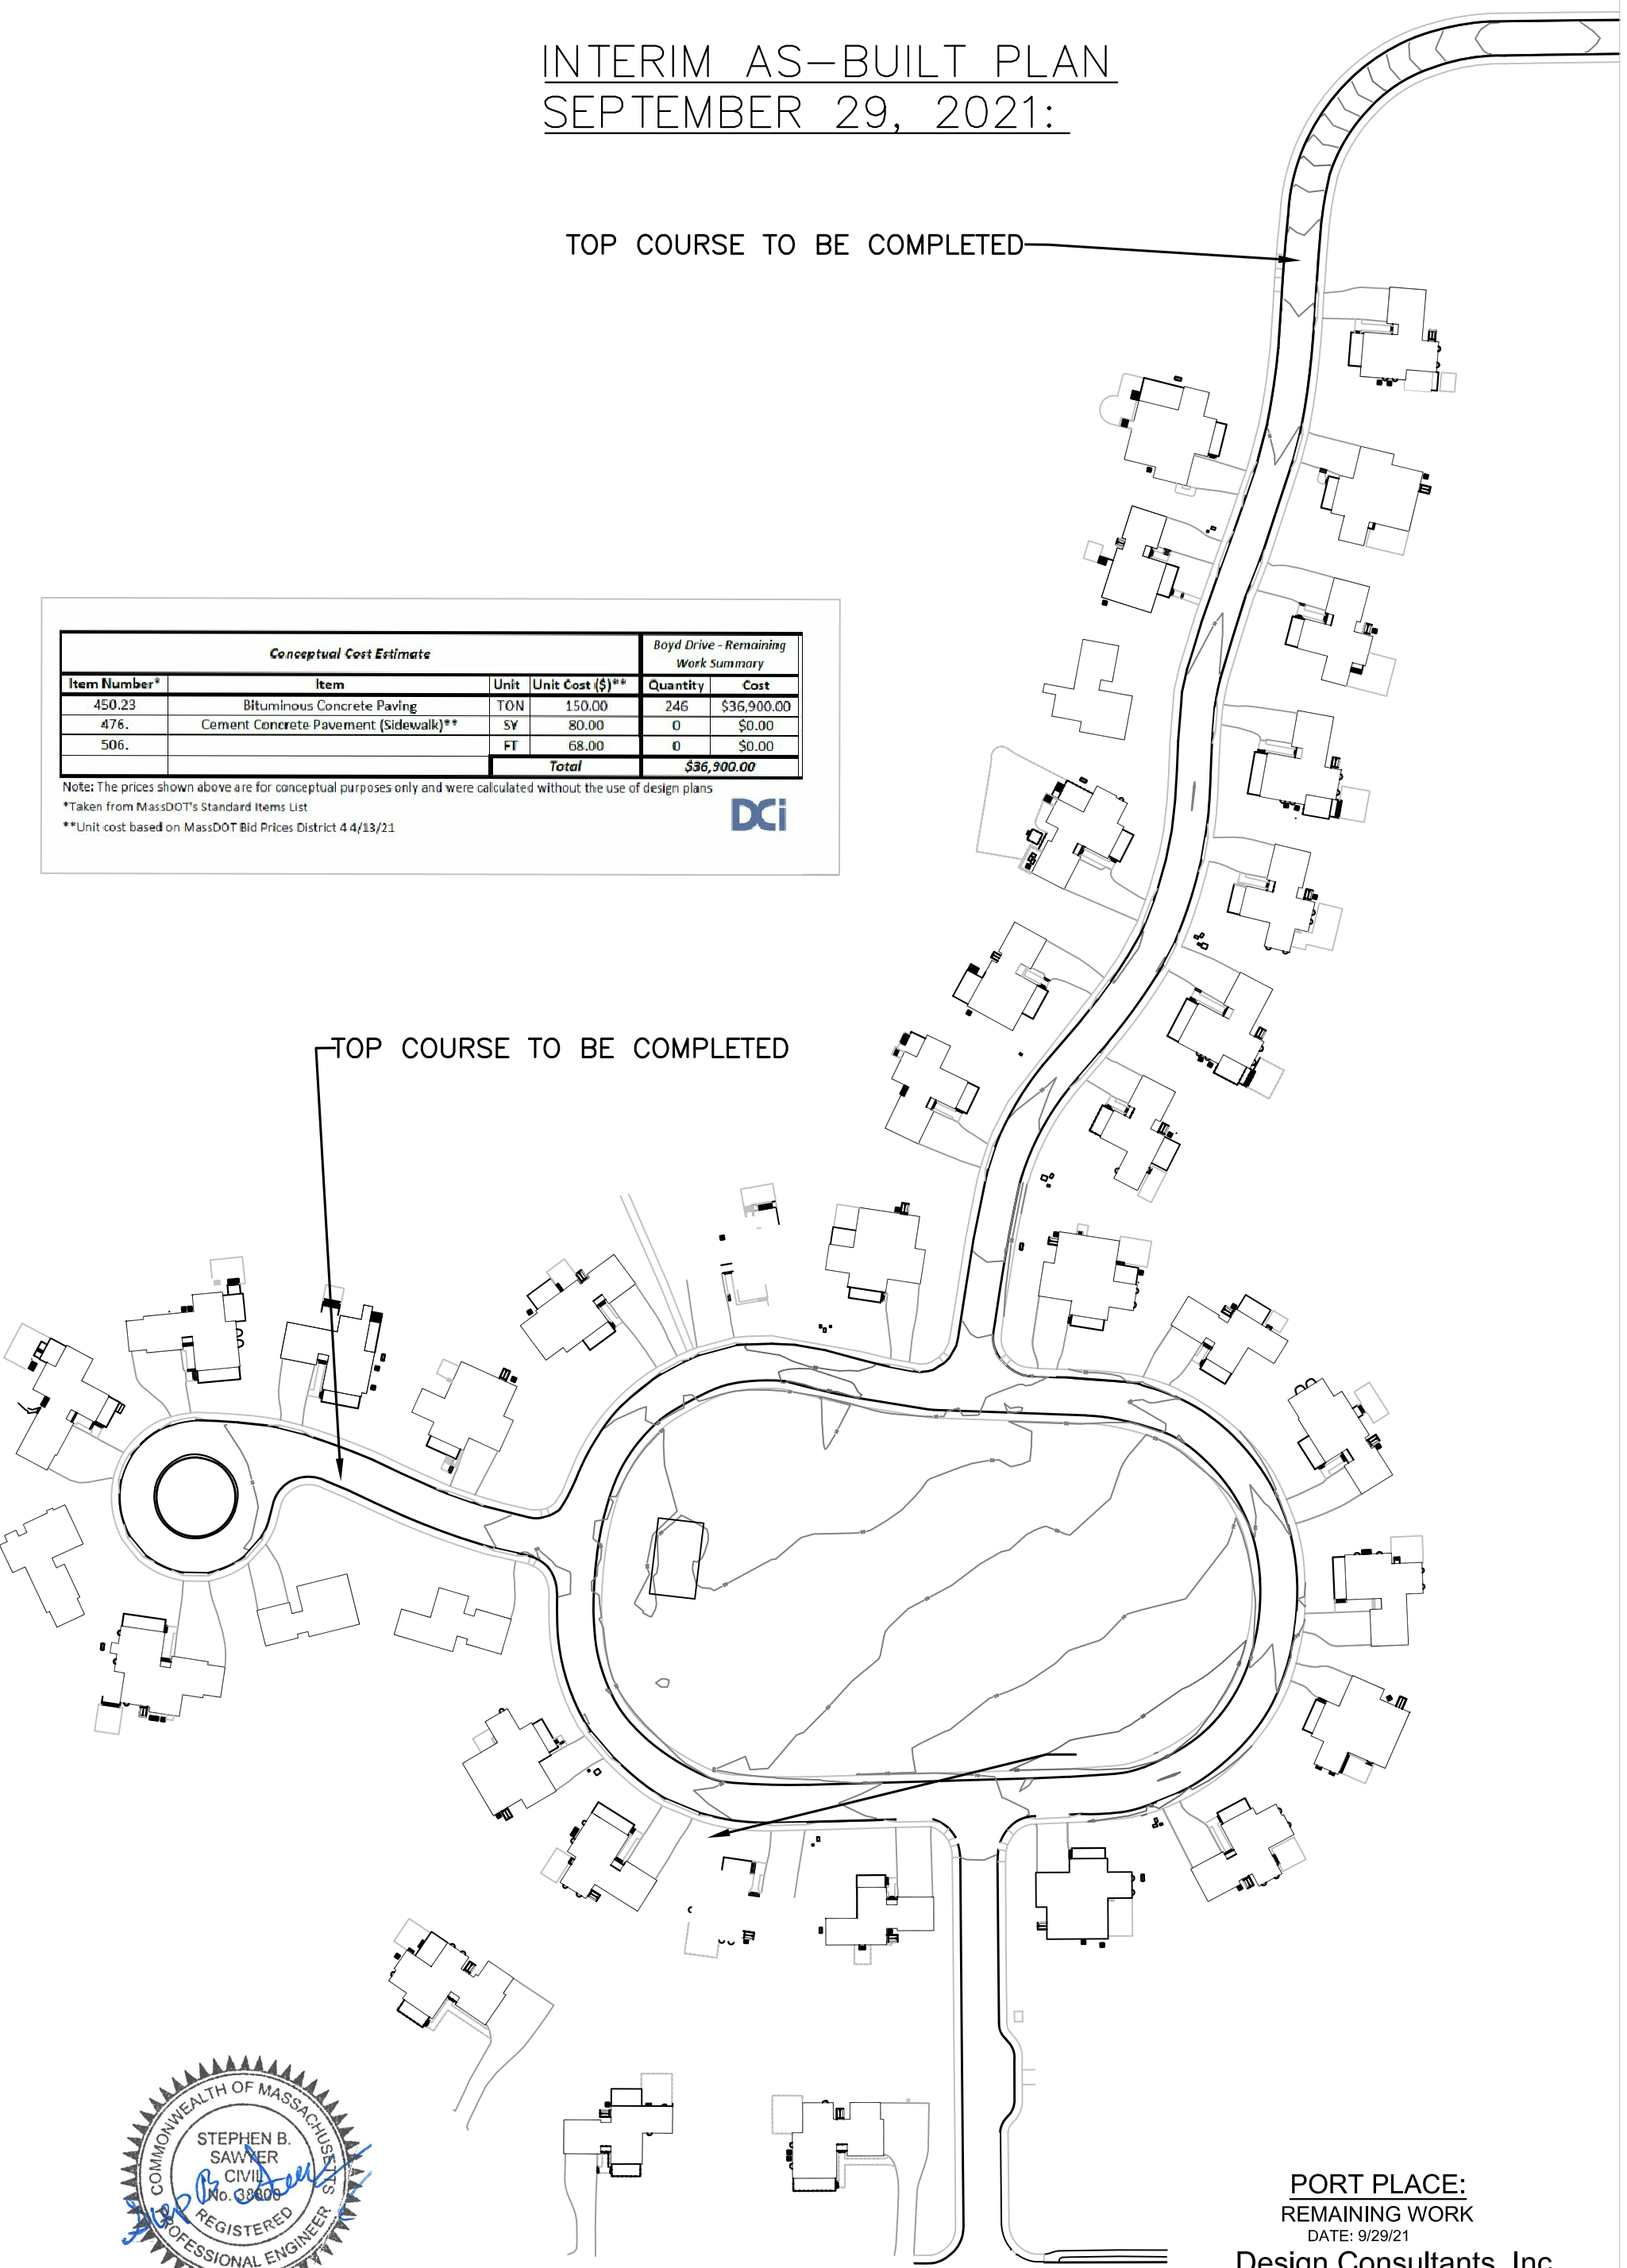

**PORT PLACE:
REMAINING WORK**
DATE: 9/29/21
Design Consultants, Inc.
CIVIL ENGINEERS and LAND SURVEYORS
SOMERVILLE - NEWBURYPORT - QUINCY
PHONE: 617-776-3350 WEBSITE: WWW.DCI-MA.COM

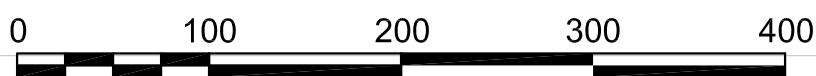

SCALE: 1" = 100'