

RECEIVED

NOV 27 2019

**Newburyport Historical Commission
DEMOLITION PLAN REVIEW APPLICATION (Step 2)**

Newburyport Planning Dept.

Property Address: 29 Warren St.

Description of the building or structure (or part thereof) to be demolished:


Garage/barn-like building

Describe reasons for demolition:


Terrible condition, leaning at 4°, hole cut in roof with plexiglass acting as skylight, original structure altered on inside, generally unusable except for storage.

Describe alternatives to demolition that have been considered:

Please attach additional pages if necessary.

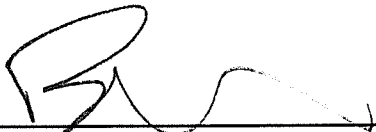Applicant's Signature  Date 11/27/19

Owner's Signature (if different) _____ Date _____

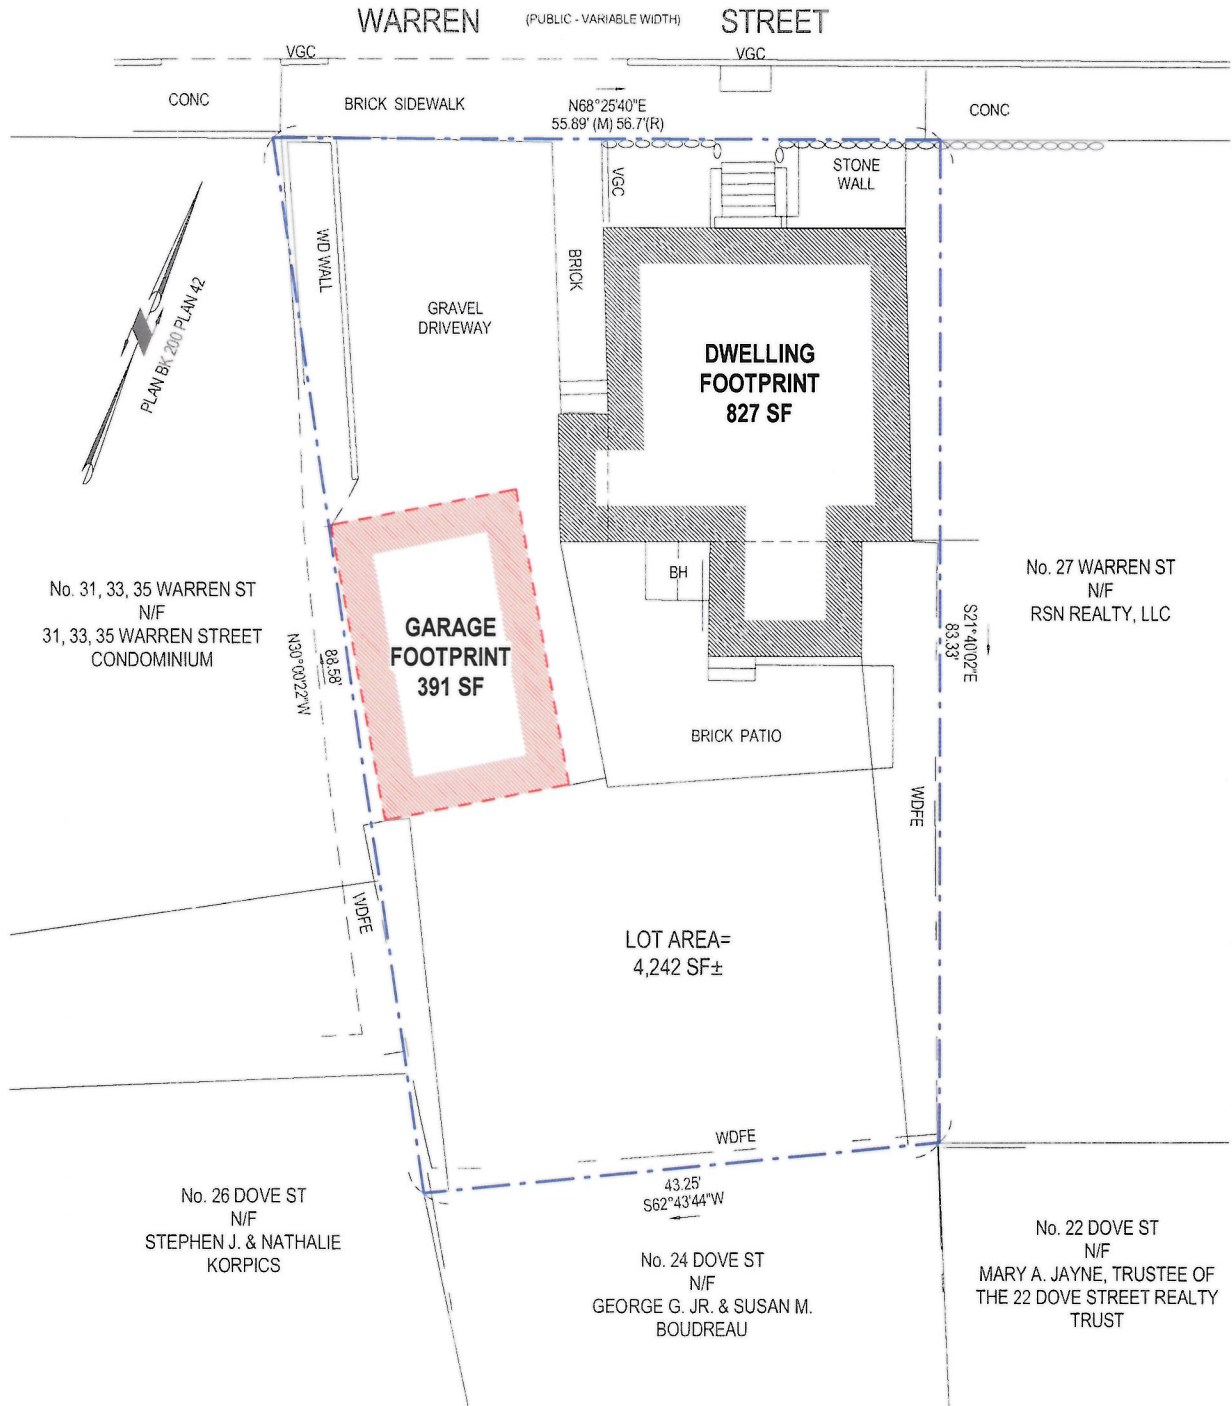


SP1 Callahan Residence
29 Warren Street
Newburyport MA 01950

Site Plan - Demolition
Scale: 1/16" = 1'-0"
11.27.19




emeritus

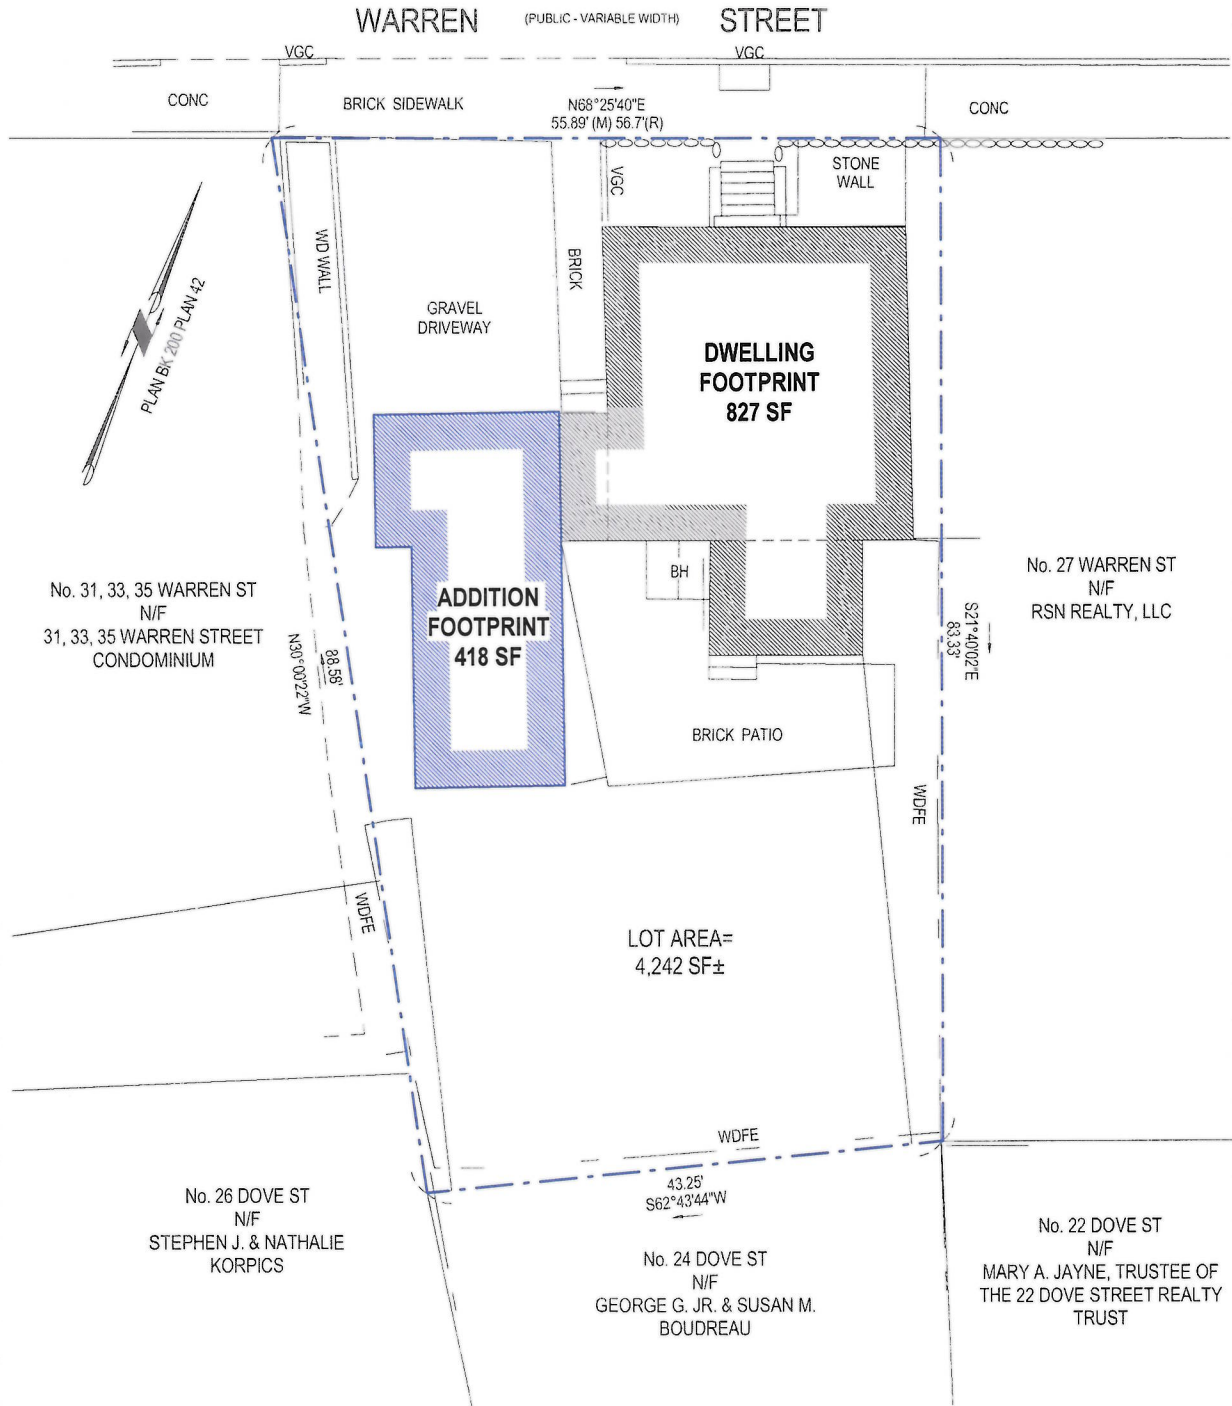


SP2 *Callahan Residence*
29 Warren Street
Newburyport MA 01950

Site Plan - Proposed
Scale: 1/16" = 1'-0"
11.27.19




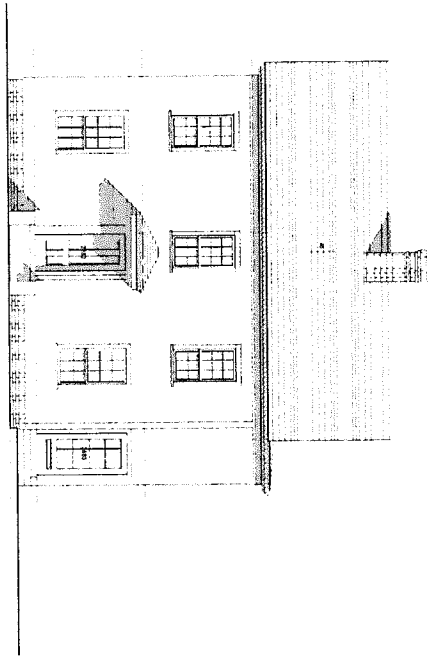


North Elevation - Existing
1/8" = 1'-0"

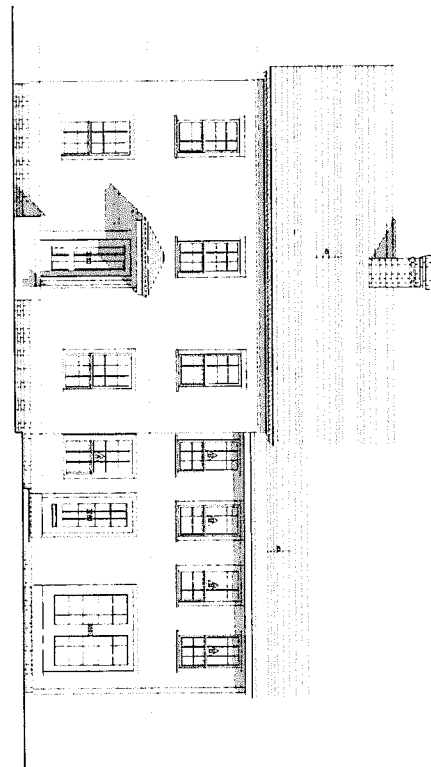

North Elevation - Proposed
1/8" = 1'-0"

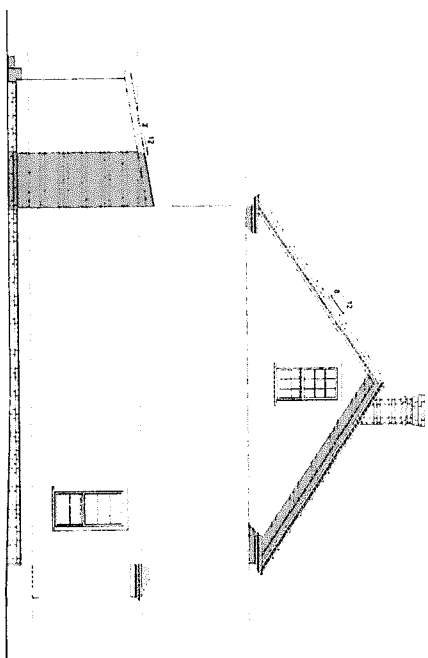

East Elevation - Existing
1/8" = 1'-0"

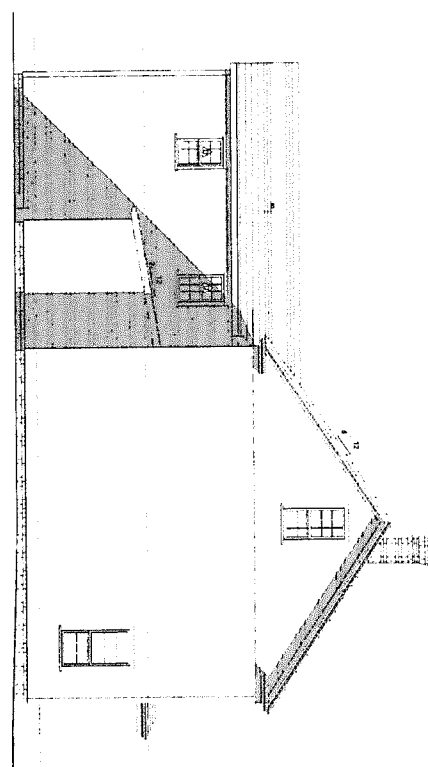

East Elevation - Proposed
1/8" = 1'-0"

1916
Callahan Residence

29 Warren Street
Newburyport, MA 01950




Exterior Elevations

Site Information


14.500 #
15.000 #
15.500 #
SHEET INDEX
 011 - Decking
 012 - Foundation
 013 - Foundation
A.2.1
1916

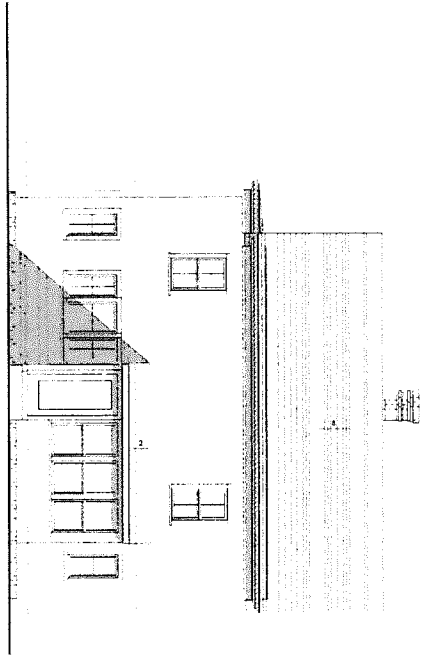


South Elevation - Existing

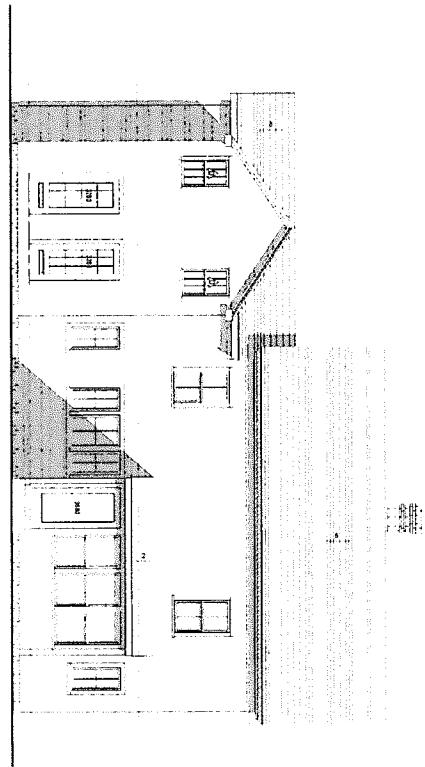

South Elevation - Proposed

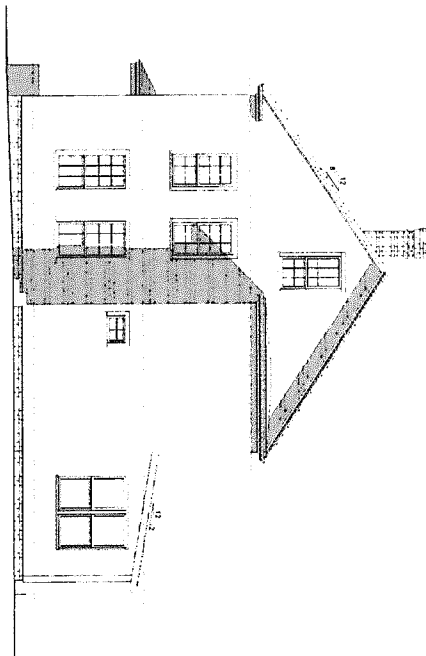

West Elevation - Existing

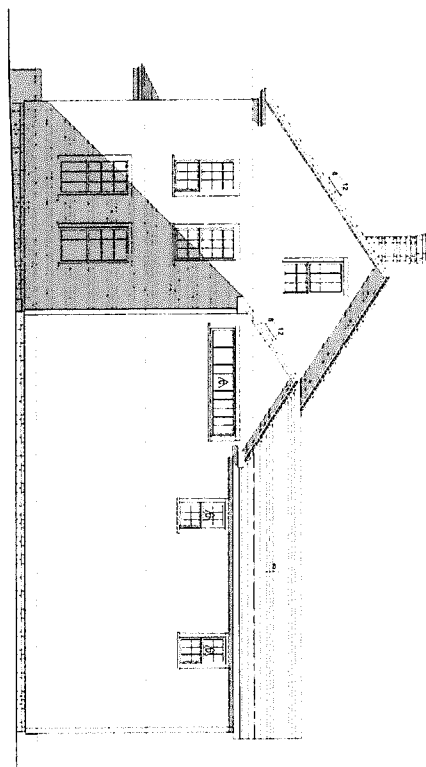

West Elevation - Proposed

1916

Callahan Residence

29 Warren Street
Newburyport, MA 01950



Emeraldus Architecture

Exterior Elevations

Site Information
 Date: 11/21/19
 Client: Emeraldus Architecture
 Project: 1916
 Location: Newburyport, MA
 Architect: Emeraldus Architecture
 1111 Main Street, Suite 100
 Newburyport, MA 01950
 Phone: 978.335.1111
 Email: info@emeraldus.com

SHEET INDEX
 A.11 Exterior Elevation
 A.12 Exterior Elevation
 A.13 Exterior Elevation
 A.14 Exterior Elevation
 A.15 Exterior Elevation
 A.16 Exterior Elevation
 A.17 Exterior Elevation
 A.18 Exterior Elevation
 A.19 Exterior Elevation
 A.20 Exterior Elevation
 A.21 Exterior Elevation
 A.22 Exterior Elevation

A.2.2
 1916